

THIS ITEM HAS BEEN DIGITALLY SIGNED AND SEALED BY

ON THE DATE ADJACENT TO THE SEAL

PRINTED COPIES OF THIS DOCUMENT ARE NOT CONSIDERED SIGNED AND SEALED AND THE SIGNATURE MUST BE VERIFIED ON ANY ELECTRONIC COPIES.

HARDESTY & HANOVER, LLC 5110 EISENHOWER BLVD., SUITE 310, TAMPA, FL 33634 TRAVIS M. KIMMINS, P.E. NO. 87786

THE ABOVE NAMED PROFESSIONAL ENGINEER SHALL BE RESPONSIBLE FOR THE FOLLOWING SHEETS IN ACCORDANCE WITH RULE 61G15-23.004, F.A.C.

SHEET NO.	SHEET DESCRIPTION
B1-2	SIGNATURE SHEET
BQ1-2	SUMMARY OF QUANTITIES (2 OF 3)
B1-15	GENERAL MACHINERY NOTES
B1-17	SPAN DRIVE MACHINERY ELEVATION

BRIDGE NO. 124134

i		REVI	SIONS			TRAVIS M. KIMMINS, P.E.	DRAWN BY:		LEE COU		SHEET TITLE:		REF. DWG. NO.	.0.
DATE	BY	DESCRIPTION	DATE	BY	DESCRIPTION	P.E. LICENSE NUMBER 87786	VR 07-24 CHECKED BY:	DEPAI		ANSPORTATION	1	SIGNATURE SHEET		-
						HARDESTY & HANOVER, LLC	TMK 07-24			_				
						5110 EISENHOWER BLVD, SUITE 310	DESIGNED BY:	ROAD NO.	COUNTY	FINANCIAL PROJECT ID	PROJECT NAME:		SHEET NO.	
			1			TAMPA, FLORIDA 33634	VR 07-24	00.70	,,,,,	453997 - 1 - 58 - 01	l	MATLACHA BASCULE BRIDGE EMERGENCY REPAIRS		_
			1			,	CHECKED BY:	CR /8	LEE	CN-1414-218	1	MAILACHA DASCULE DRIDGE EMERGENCI REPAIRS	B1-2	
			1				TMK 07-24			0.1 1.1.1 2.10			1	

			SUMMARY OF ST	RUCTUF	RE QUA	NTITIES	5		
SECT I ON	PAY ITEM NO.	PAY ITEM DESCRIPTION	LOCATION	UNIT	QUAI P	NT ITY	TO P	DESIGN NOTES	CONSTRUCTION REMARKS
	465-2-122	MOVABLE BRIDGE MACHINERY & CASTING - REHABILITATION, FURNISH & INSTALL, SPHERICAL BEARINGS	BASCULE SPAN 7	EA		6.0/2		6 🖄	
	465 - 2 - 421	MOVABLE BRIDGE MACHINERY & CASTING - REHABILITATION, RECONDITION, PLAIN JOURNAL BEARINGS	BASCULE SPAN 7	EA		4.0		4	
	465 - 2 - 452	MOVABLE BRIDGE MACHINERY & CASTING-REHABILITATION, RECONDITION, HYDRAULIC CYLINDER	BASCULE SPAN 7	EA		2.0		2	
	465 - 2 - 454	MOVABLE BRIDGE MACHINERY & CASTING-REHABILITATION, RECONDITION, HYDRAULIC POWER PACK	BASCULE SPAN 7	EA		1.0		1	
	465 - 2 - 505	MOVABLE BRIDGE MACHINERY & CASTING - REHABILITATION, ADJUST & MODIFY, SPAN LOCKS	BASCULE SPAN 7	A5		2.0		2	
	465 - 2 - 508	MOVABLE BRIDGE MACHINERY & CASTING - REHABILITATION, ADJUST/MODIFY LIVE LOAD SHOES	BASCULE SPAN 7	LS		1.0		1	
MOVABLE BRIDGE / MECHANICAL	465 - 2 - 660	MOVABLE BRIDGE MACHINERY & CASTING-REHABILITATION, REMOVE & DISPOSE, OTHER MACHINERY COMPONENTS	BASCULE SPAN 7	LS		1.0		1	
<u> </u>	<del>465-3-17</del>	MOVABLE BRIDGE COUNTERWEIGHT, F&I, BALANCE BLOCKS	BASCULE SPAN 7	LS		1.0		1	
	465-3 50	MOVABLE BRIDGE COUNTERWEIGHT, ADJUST	BASCULE SPAN 7	EA		1.0		INCLUDE SPAN BALANCING TESTING 1 ONLY TO CONFIRM PROPER BALANCE, NO ADJUSTMENTS ANTICIPATED.	<u>^</u>
<u> </u>	<del>465 - 3 - 96</del>	MOV ABLE BRIDGE COUNTERWEIGHT, CLEAN, POCKETS	BASCULE SPAN 7	EA		2.0		2	
	465 - 20	MOVABLE BRIDGE- PREVENTATIVE MAINTENANCE & ROUTINE REPAIR	BASCULE SPAN 7	LS		1.0		1	
	465 - 21	MOVABLE BRIDGE OPERATOR	BASCULE SPAN 7	LS		1.0		1	
	465-71-3	MOVABLE BRIDGE FUNCTIONAL CHECKOUT, PHASE C, COMPLETE	BASCULE SPAN 7	LS		1.0		1	
MOVABLE BRIDGE / CONTROL HOUSE	512-71 1	MOVABLE BRIDGE-PLUMBING SYSTEM, F&I (INCLUDES NEW HANGERS)	BASCULE SPAN 7	EA		1.0		1	

NOTES: 1. FOR PAY ITEM NOTES, SEE SHEET NO. B1-5.

		REVIS	SIONS			TRAVIS M. KIMMINS, P.E.
DATE	BY	DESCRIPTION	DATE	BY	DESCRIPTION	P.E. LICENSE NUMBER 87786
1/25	PCR	REMOVED PAY ITEM NUMBERS  1 465-3-17 465-3-96. ADDED DESIGN NOTES.				HARDESTY & HANOVER, LLC 5110 EISENHOWER BLVD, SUITE 310
2/25	VR	2 UPDATED PAY ITEM QTY.				TAMPA, FLORIDA 33634

DRAWN BY VR 07-24		LEE COUN		SHE
CHECKED BY: TMK 07-24	DEPAR	RTMENT OF TRA	ANSPORTATION	
DESIGNED BY:	ROAD NO.	COUNTY	FINANCIAL PROJECT ID	PRO
VR 07-24			453997 - 1 - 58 - 01	l
CHECKED BY:	CR 78	LEE	CN-1414-218	l

SUMMARY OF QUANTITIES (2 OF 3) MATLACHA BASCULE BRIDGE EMERGENCY REPAIRS

REF. DWG. NO. SHEET NO. BQ1-2

BRIDGE NO. 124134

## MECHANICAL GENERAL NOTES:

DETAILS OF MACHINERY TO CONFORM TO THE AASHTO LRFD MOVABLE HIGHWAY BRIDGE DESIGN SPECIFICATIONS CURRENT EDITION, AND ALL SUBSEQUENT INTERIMS, UNLESS OTHERWISE SHOWN ON THE PLANS, OR PROVIDED FOR IN THE SPECIFICATIONS. REFER TO TSP SECTIONS T465 MOVABLE BRIDGES AND T468 MECHANICAL CONSTRUCTION FOR MOVABLE BRIDGES FOR ADDITIONAL REQUIREMENTS.


PROVIDE SHIMS FOR LEVELING AND ALIGNING ALL MACHINERY COMPONENTS. PROVIDE SHIMS AT ½" NOMINAL THICKNESS, UNLESS OTHERWISE SPECIFIED, WITH ADJUSTMENT VARIATIONS AS DESCRIBED IN THE TECHNICAL SPECIAL PROVISION SECTION T468.

UNLESS OTHERWISE INDICATED, PROVIDE ALL FASTENERS USED FOR CONNECTING MACHINERY PARTS TO EACH OTHER AND TO SUPPORTING STEEL TO BE TURNED BOLTS THAT CONFORM TO THE MINIMUM SPECIFIED PHYSICAL REQUIREMENTS OF HIGH STRENGTH, ASTM A449 TYPE 1, CUT THREAD, SEMI-FINISHED, WASHER FACED, HEAVY HEXAGONAL BOLTS. THE DIMENSIONS OF THE BOLT HEADS TO BE PROVIDED TO CONFORM TO ANSI/ASME B18.2.6 - HEAVY HEX STRUCTURAL BOLTS. PROVIDE STRUCTURAL BOLTS TO MEET ASTM F3125 GRADE A325 TYPE I SPECIFICATIONS.

PROVIDE THREADS FOR TURNED BOLTS THAT CONFORM TO COARSE THREAD SERIES AS PER THE REQUIREMENTS OF ANSI/ASME B.1.1. ALL TURNED BOLTS ARE TO BE SECURED WITH DOUBLE HEAVY HEX NUTS UNLESS OTHERWISE SPECIFIED. NUTS TO CONFORM TO ASTM A563, HEAVY HEX NUTS, ANSI/ASME 18.2.2. USE JAM NUTS ONLY WHERE SPACE PROHIBITS USE OF STANDARD NUTS. PROVIDE HARDENED STEEL, PLAIN WASHERS CONFORMING TO ASTM F436 TO BE USED AT BOTH ENDS OF ALL TURNED BOLTS.

BOLT HOLE CLEARANCE FOR TURNED BOLTS/FASTENERS TO BE LC6 UNLESS OTHERWISE NOTED. HIGH STRENGTH TURNED BOLTS THAT HAVE BEEN TORQUED ARE NOT BE REUSED. TURNED BOLTS TO BE DRILLED AND REAMED IN THE FIELD AFTER FINAL ALIGNMENT UNLESS OTHERWISE NOTED. REFER TO TSP SECTION T468 FOR BOLT TENSIONING REQUIREMENTS.

## TYPICAL H.S. TURNED BOLT DETAIL

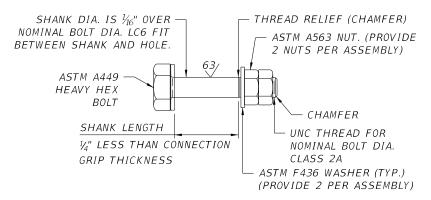

DETAIL THE EDGES AND CORNERS OF ALL MACHINERY PARTS AND MACHINE WITH SUITABLE FILLETS AND CHAMFERS. IN GENERAL THE MINIMUM RADIUS OR CHAMFER TO BE ¾" IF THE PART THICKNESS IS LESS THAN 1" AND ¼" IF THE PART THICKNESS IS EQUAL TO OR GREATER THAN 1", UNLESS NOTED OTHERWISE. IN THE CASE OF MATING PARTS, ALLOWANCE TO BE MADE FOR THE PROPER FIT AND ASSEMBLY. PROVIDE SUCH DETAILS ON SHOP DRAWINGS.

ALL CORNERS AND EDGES OF CASTINGS TO HAVE SUITABLE FILLETS AND RADII. IN GENERAL, PROVIDE THE FILLET OR RADII TO BE A MINIMUM OF ½" R FOR SECTIONS EQUAL OR GREATER THAN 2" AND ¼" R FOR SECTIONS LESS THAN 2". CASTINGS TO BE PROVIDED WITH A SPOT FACE FOR VERTICAL MOUNTING BOLTS AND A BOSS FOR HORIZONTAL MOUNTING BOLTS. BOSSES TO HAVE A HEIGHT OF ¼" AND HAVE A MINIMUM DIAMETER OF ½" PLUS THE NOMINAL WASHER DIAMETER. SPOT FACES TO BE ¼6" DEEP AND HAVE A MINIMUM DIAMETER OF ½" PLUS THE NOMINAL WASHER DIAMETER. ADHERE TO THE PROPER CASTING AND COOLING PROCESSES, SO THAT SURFACE SHRINKAGE CRACKS ARE ELIMINATED.

MACHINERY DIMENSIONS SHOWN ON DRAWINGS ARE DIMENSIONS AFTER MACHINING. UNLESS OTHERWISE INDICATED OR REQUIRED FOR THE PROPER ASSEMBLY OF PARTS, DIMENSIONAL TOLERANCES FOR MACHINERY IN GENERAL TO BE IN INCHES AS FOLLOWS:

SURFACE

STRAIGHTNESS:	_ 0.010
FLATNESS:	<i>□</i> 0.010
PARALLELISM: (PER LINEAR FOOT):	0.005 -
PERPENDICULARITY (PER LINEAR FOOT):	
ANGULARITY (PER LINEAR FOOT):	∠ 0.02 -
POSITION (FEATURES WITHIN A COMPONENT):	<b>⊕</b> 0.02 -
CONCENTRICITY:	© 0.005 -
CIRCULAR RUNOUT:	> 0.005 -

DETAILS SHOWN HEREIN WITH DIMENSIONS DEPEND ON MANUFACTURED ITEMS AND ARE TO BE SIZED BASED ON THE ACTUAL MANUFACTURED ITEMS PURCHASED BY THE CONTRACTOR.

UNLESS NOTED OTHERWISE, DIMENSIONS BETWEEN MACHINED SURFACES

UNLESS NOTED OTHERWISE, PROVIDE FITS AND FINISHES FOR

HAVE A TOLERANCE OF 0.010-INCH.

MACHINERY AS FOLLOWS:

SURFACE	FINISH	F 17
MACHINERY BASE ON STEEL	125	-
MACHINERY BASE ON MASONRY	250	-
MACHINERY SUPPORTS	125	-
MACHINERY PARTS IN FIXED CONTACT	125	-
SHAFT JOURNAL	8	RCe
JOURNAL BUSHINGS	16	RC
HUBS ON SHAFTS (TO 2" BORE)	<i>32</i>	FN
HUBS ON SHAFTS (OVER 2" BORE)	63	FN.
SPLIT BUSHINGS IN BASE	125	LCI
SOLID BUSHING IN BASE (TO 1/4" WALL)	63	FN
SOLID BUSHING IN BASE (OVER 1/4" WALL)	63	FN.
SLIDING AND THRUST BEARINGS	<i>32</i>	RCe

THE ABOVE FITS FOR CYLINDRICAL PARTS TO ALSO APPLY TO THE MAJOR DIMENSIONS OF NON-CYLINDRICAL PARTS.


ALL TRANSITIONS OF SURFACES OF MACHINERY PARTS TO BE BLENDED IN SMOOTH. ALL SURFACES OF FORGINGS TO BE MACHINED TO THE DIMENSIONS SHOWN IN THE CONTRACT DOCUMENTS. ALL MATING SURFACES OF MACHINERY PARTS AND SUPPORTS ARE TO BE MACHINED.

PAINT MACHINERY IN ACCORDANCE WITH SPECIFICATIONS. PROVIDE THREE-PART MACHINERY PAINT SYSTEM: ALUMINUM, EPOXY MASTIC PRIME AND INTERMEDIATE COATS, ALIPHATIC POLYURETHANE TOPCOAT. PAINT PER FDOT STANDARD SPECIFICATION SECTION 560 AND 561. REFER TO TSP SECTION T468 FOR ADDITIONAL MACHINERY PAINTING DETAILS.

## MECHANICAL SCOPE OF WORK:

SEE TSP FOR A COMPLETE ITEM LIST OF ASSOCIATED ITEMS TO BE REPLACED.

- 1. RECONDITION SPAN DRIVE HYDRAULIC SYSTEM (REFER TO REF. DWG. NO. BM-2 AND BM-3)
  - A. RECONDITION (1) HYDRAULIC POWER UNIT AND ASSOCIATED HARDWARE. REFER TO TSP FOR ADDITIONAL INFORMATION. SEE REF. DWG. NO. BM-4 THRU BM-8.
  - B. REFURBISH (4) PLAIN CARDANIC RING BEARINGS AND PROVIDE NEW COVER PLATES.
- C. FURNISH AND INSTALL (4) PLAIN SPHERICAL BEARINGS AT CARDANIC RING ASSEMBLIES.
- D. FURNISH AND INSTALL (2) PLAIN SPHERICAL BEARINGS AT UPPER CLEVIS ASSEMBLIES.
- 2. LIVE LOAD BEARING ASSEMBLY (REFER TO REF. DWG. NO. BM-10)
- A. SHIM AND ADJUST (2) LIVE LOAD SHOE ASSEMBLIES.
- 3. SPAN LOCK MACHINERY (REFER TO REF. DWG. NO. BM-9)
- A. SHIM AND ADJUST (2) SPAN LOCK ASSEMBLIES. COORDINATE WORK WITH LIVE LOAD BEARING ASSEMBLY SHIM WORK.
- 4. PERFORM SPAN BALANCE TESTING, ADJUST SPAN BALANCE AND CLEAN COUNTERWEIGHT POCKETS COVERED UNDER ITEMS 465-3-17, 50 & 96. REFER TO TSPS FOR ADDITIONAL INFORMATION.

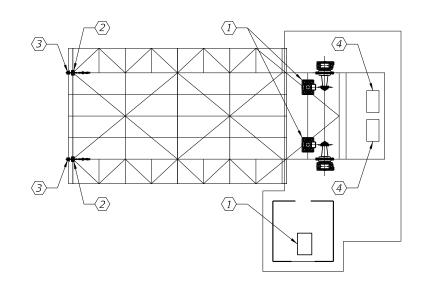


BRIDGE B1 - 124134

BRIDGE LAYOUT KEY PLAN

*BRIDGE NO. 124134* 

	REVI	SIONS		TRAVIS M. KIMMINS, P.E.	DRAWN BY:		LEE COU	NTY	SHEET TITLE:		REF. DWG. NO.
DATE BY	DESCRIPTION	DATE BY	DESCRIPTION	P.E. LICENSE NUMBER 87786 HARDESTY & HANOVER, LLC	VR 07-24 CHECKED BY: TMK 07-24	DEPA		ANSPORTATION		GENERAL MACHINERY NOTES	BM-1
2/25 VR	2 ADDED NOTE 1D TO SCOPE.			5110 EISENHOWER BLVD, SUITE 310 TAMPA, FLORIDA 33634	DESIGNED BY: VR 07-24	ROAD NO.	COUNTY	FINANCIAL PROJECT ID  453997 - 1 - 58 - 01	PROJECT NAME:		SHEET NO.
				TAMPA, FLORIDA 33034	CHECKED BY: TMK 07-24	CR 78	LEE	CN - 1414 - 218		MATLACHA BASCULE BRIDGE EMERGENCY REPAIRS	B1 - 15



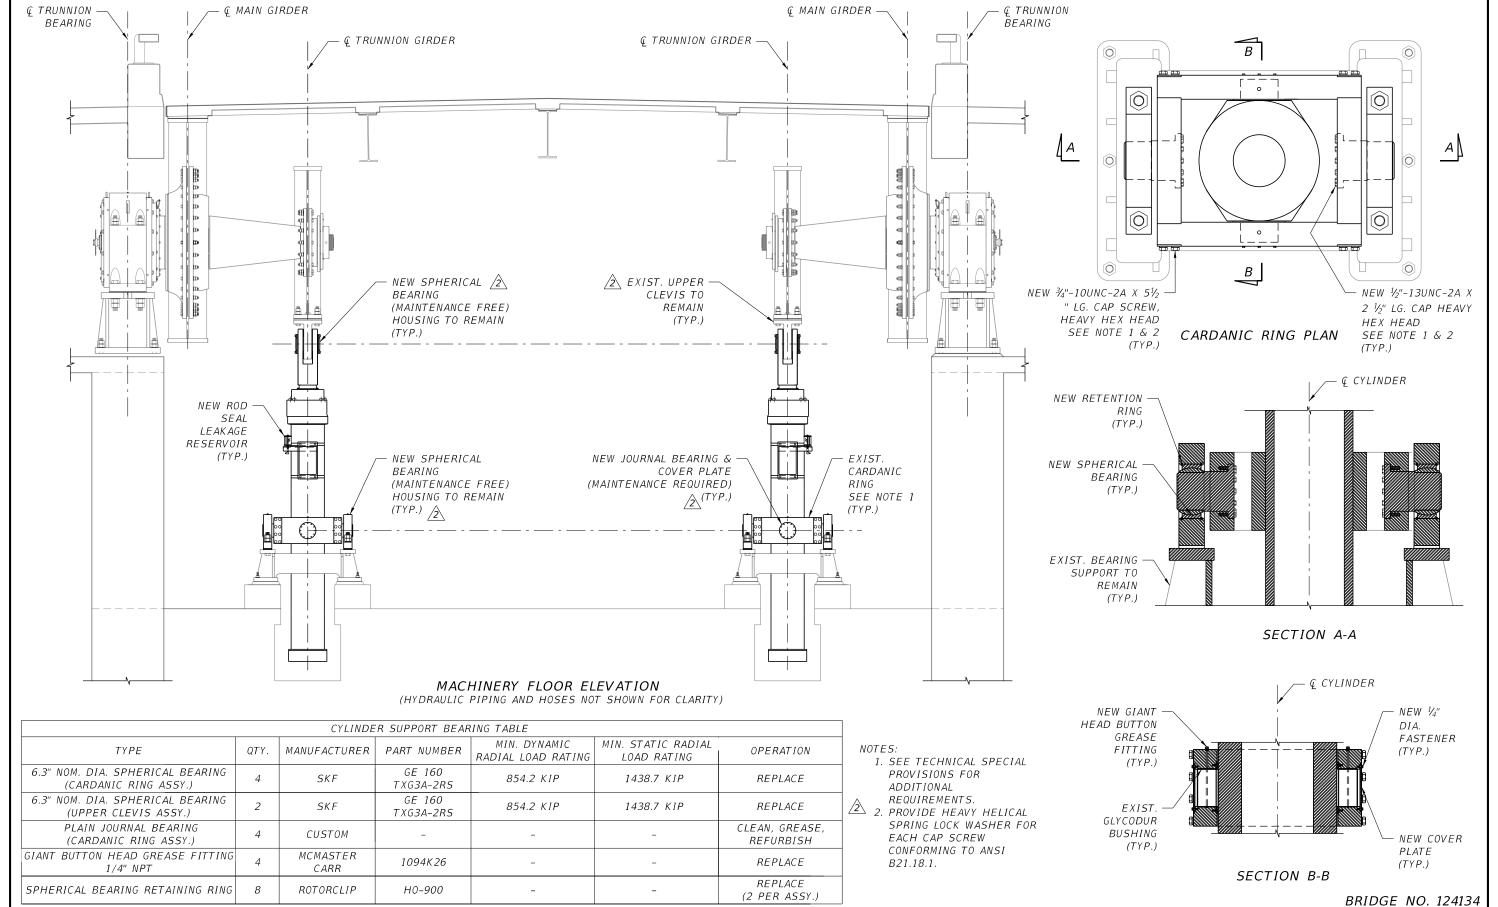

REVISIONS REF. DWG. NO TRAVIS M. KIMMINS, P.E. LEE COUNTY SPAN DRIVE MACHINERY ELEVATION P.E. LICENSE NUMBER 87786 DEPARTMENT OF TRANSPORTATION CHECKED BY: BM-3 HARDESTY & HANOVER, LLC TMK 07-24 ADDED/UPDATED CALL OUT. UPDATED TABLE ITEMS. FINANCIAL PROJECT ID 5110 EISENHOWER BLVD, SUITE 310 DESIGNED BY VRSHEET NO. TAMPA, FLORIDA 33634 453997 - 1 - 58 - 01 MATLACHA BASCULE BRIDGE EMERGENCY REPAIRS CHECKED BY: CN-1414-218