


1/16/2015 8:47:37 AM - P:\HWK354\400-6354-1401\CAD\SETFILES\M-101 TO M-104 PINE ISLAND MODS.DWG - MARGUEZ, GERMAN

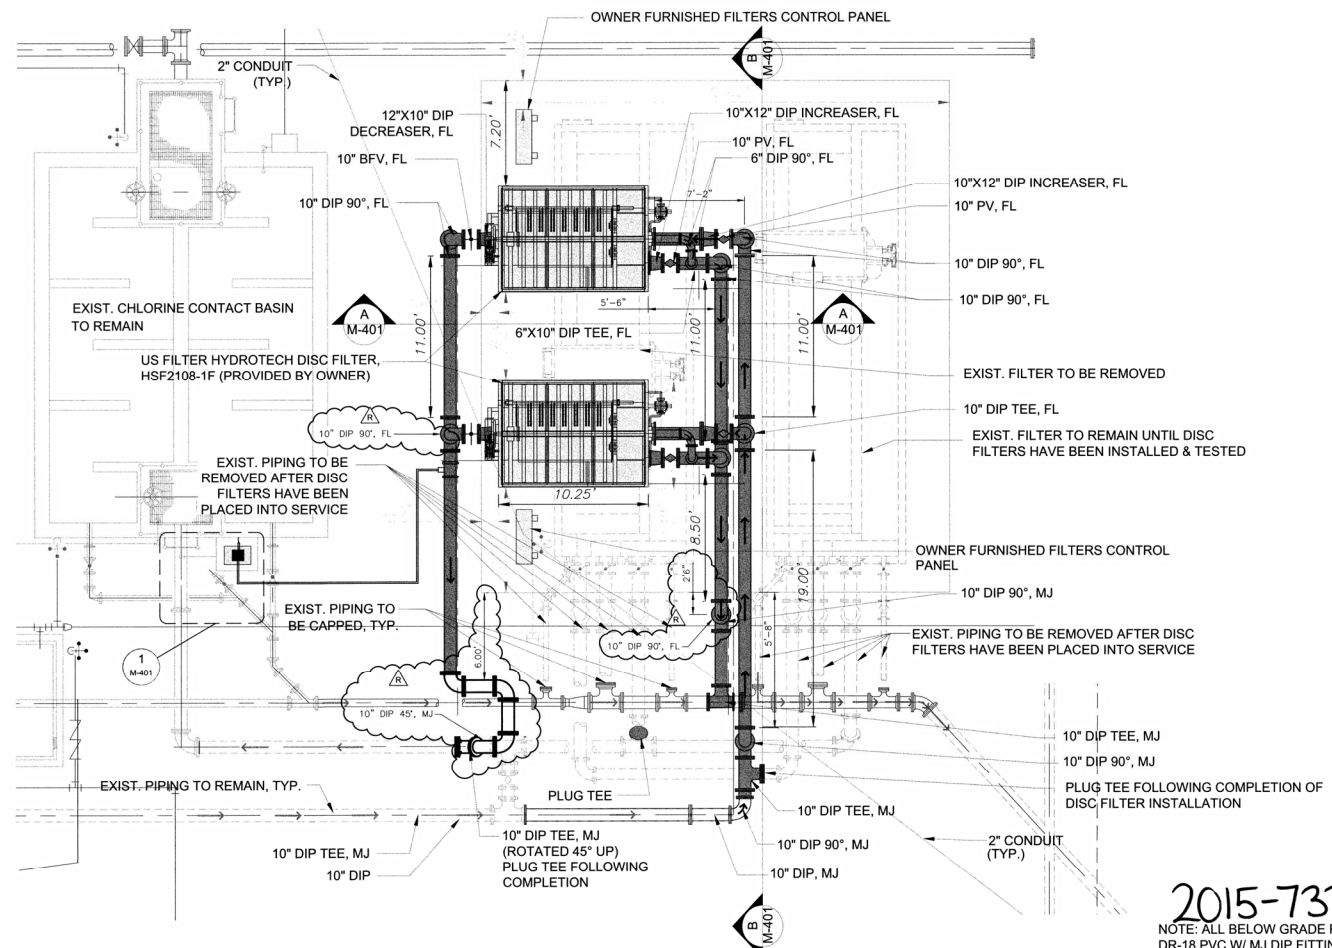

NEW FILTERS AND PIPE MODIFICATIONS
SCALE: 1/4" = 1'-0"

2015-7331-08
NOTE: ALL BELOW GRADE PIPING SHALL BE DR-18 PVC W/ MJ DIP FITTINGS. ALL ABOVE GROUND PIPING SHALL BE FLANGED DIP. ALL PIPING SHALL BE BROWN IN COLOR. ALL DIP SHALL BE LINED WITH PROTECTO 401 CERAMIC EPOXY 40 MILS DFT.



TETRA TECH		www.tetrad.com 11850 CHEVROLET ESTERO, FL 33928 PHONE: (239) 390-1487 FAX: (239) 390-1789	
		MITCHELL & STARK	
LEE COUNTY MULTIPLANT FLORIDA		BY: DATE: DESCRIPTION: RECORDS DWG	
PINE ISLAND, FLORIDA		PROJECT NO: 200-63854-14001	
LEE COUNTY UTILITIES		DESIGNED BY: TV	
PINE ISLAND WWTP IMPROVEMENTS		DRAWN BY: JW	
NEW FILTERS AND PIPE MODIFICATIONS		CHECKED BY: DM	
M-102		Copyright: Tetra Tech	

Bar Measures 1 inch